



INSITE TOWERS,
27 Vuna Close,
Umhlanga Ridge,
4319

2020 INSITE SITES



Abbott Technologies (Pty) Ltd,
Unit 22 Briarpark,
10 Queen Nandi Drive,
Briardene, Durban, 4051

CLIENT: **INSITE TOWERS,**
27 Vuna Close,
Umhlanga Ridge,
4319

TURN-KEY CONTRACTOR:
ABBOTT TECHNOLOGIES
ABBOTT TECHNOLOGIES
(PTY) LTD, UNIT 22 BRIAR
PARK, 10 QUEEN NANDI DRIVE,
BRIARDENE, DURBAN, 4051

NOTES:
1.
2.
3.
4.
5.
6.
7.
8.
9.
10.

PROJECT:
2020 INSITE TOWERS SITES

OWNER:
INSITE TOWERS

PROPERTY DESCRIPTION:
PROPOSED NEW 10m x 10m SITE WITH
A 35m HIGH LATTICE AND
OUTDOOR EQUIPMENT PLINTHS

SITE ADDRESS:
-

LATITUDE: -33.7939602

LONGITUDE: 23.6248031

SITE NAME:
LOUTERWATER

NUMBER:
ISSA 491

SURVEY DATE:
03/09/20

DRAWN BY:
S.JVR

DATE:
04/09/20

Scale: NTS
Drawing Reference:
COVER PAGE
ABTE00000
REV: 1

DIMENSIONS TO BE VERIFIED ON SITE
BEFORE COMMENCEMENT OF ANY WORK.
DRAWINGS MUST NOT BE SCALED.
ONLY FIGURED DIMENSIONS TO BE USED.

LANDLORDS DETAIL:	CLIENT APPROVAL:	INSITE QC APPROVAL:	INSITE PROJECT MANAGER APPROVAL:	NO	DATE	DESCRIPTION
NAME:	NAME:	NAME:	NAME:	0	25/11/18	ISSUE FOR CONSTRUCTION
PHONE NO.:	SIGNATURE:	SIGNATURE:	SIGNATURE:	1	03/12/18	AS BUILT
DATE:	DATE:	DATE:	DATE:			

GENERAL DRAWING LIST

- 00 – INDEX LIST
- 01 – SITE LOCALITY MAP
- 02 – CADASTRAL MAP
- 03 – SITE PLAN LAYOUT
- 04 – BTS LAYOUT
- 05 – PLINTH DETAIL
- 06 – ELEVATION

CLIENT: **INSITE TOWERS,**
27 Vuna Close,
Umhlanga Ridge,
4319

TURN-KEY CONTRACTOR:
ABBOTT TECHNOLOGIES
ABBOTT TECHNOLOGIES
(PTY) LTD, UNIT 22 BRIAR
PARK, 10 QUEEN NANDI DRIVE,
BRIARDENE, DURBAN, 4051

NOTES:

-
-
PROJECT:

2020 INSITE TOWERS SITES

OWNER:

INSITE TOWERS

PROPERTY DESCRIPTION:

PROPOSED NEW 10m x 10m SITE WITH
A 35m HIGH LATTICE AND
OUTDOOR EQUIPMENT PLINTHS

SITE ADDRESS:

LATITUDE: -33.7939602

LONGITUDE: 23.6248031

SITE NAME:

LOUTERWATER

NUMBER:

ISSA 491

SURVEY DATE:

03/09/20

DRAWN BY:

SJVR

DATE:

04/09/20

Scale: NTS

Drawing Reference:

ABTE00000

REV: 1

INDEX
SHEET 0 OF 6

DIMENSIONS TO BE VERIFIED ON SITE
BEFORE COMMENCEMENT OF ANY WORK.
DRAWINGS MUST NOT BE SCALED.
ONLY FIGURED DIMENSIONS TO BE USED.

LANDLORDS DETAIL:	CLIENT APPROVAL:	INSITE QC APPROVAL:	INSITE PROJECT MANAGER APPROVAL:	NO	DATE	DESCRIPTION
NAME:	NAME:	NAME:	NAME:	0	25/11/18	ISSUE FOR CONSTRUCTION
PHONE NO.:	SIGNATURE:	SIGNATURE:	SIGNATURE:	1	03/12/18	AS BUILT
DATE:	DATE:	DATE:	DATE:			

SITE LOCALITY MAP

-33.7939602 23.6248031

33°47'38.3"S 23°37'29.3"E

-33.793960, 23.624803

Directions

Save

Nearby

Send to your phone

Share

Kou-Kamma

6J4F+CW Louterwater

Add a missing place

Add your business

Photos

Scale: NTS

SITE LOCALITY MAP
SHEET 1 OF 6

Drawing Reference:

ABTE00000

REV: 1

CLIENT:

Insite Towers

27 Vuna Close,
Umhlanga Ridge,
4319

TURN-KEY CONTRACTOR:

ABBOTT TECHNOLOGIES

ABBOTT TECHNOLOGIES (PTY) LTD, UNIT 22 BRIAR PARK, 10 QUEEN NANDI DRIVE, BRIARDENE, DURBAN, 4051

NOTES:

1.

2.

3.

4.

5.

6.

7.

8.

9.

10.

PROJECT:

2020 INSITE TOWERS SITES

OWNER:

INSITE TOWERS

PROPERTY DESCRIPTION:

PROPOSED NEW 10m x 10m SITE WITH
A 35m HIGH LATTICE AND
OUTDOOR EQUIPMENT PLINTHS

SITE ADDRESS:

LATITUDE:

-33.7939602

LONGITUDE:

23.6248031

SITE NAME:

LOUTERWATER

NUMBER:

ISSA 491

SURVEY DATE:

03/09/20

DRAWN BY:

SJVR


DATE:

04/09/20

DIMENSIONS TO BE VERIFIED ON SITE
BEFORE COMMENCEMENT OF ANY WORK.
DRAWINGS MUST NOT BE SCALED.
ONLY FIGURED DIMENSIONS TO BE USED.

LANDLORDS DETAIL:	CLIENT APPROVAL:	INSITE QC APPROVAL:	INSITE PROJECT MANAGER APPROVAL:	NO	DATE	DESCRIPTION
NAME:	NAME:	NAME:	NAME:	0	25/11/18	ISSUE FOR CONSTRUCTION
PHONE NO.:	SIGNATURE:	SIGNATURE:	SIGNATURE:	1	03/12/18	AS BUILT
DATE:	DATE:	DATE:	DATE:			

CADASTRAL MAP

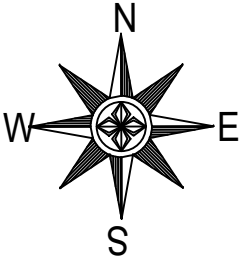

Scale: NTS

CADASTRAL MAP
SHEET 2 OF 6

Drawing Reference:
ABTE00000
REV: 1

CLIENT:

Insite Towers

INSITE TOWERS,
27 Vuna Close,
Umhlanga Ridge,
4319

TURN-KEY CONTRACTOR:

ABBOTT TECHNOLOGIES

ABBOTT TECHNOLOGIES
(PTY) LTD, UNIT 22 BRIAR
PARK, 10 QUEEN NANDI DRIVE,
BRIARDENE, DURBAN, 4051

NOTES:

1.

2.

3.

4.

5.

6.

7.

8.

9.

10.

PROJECT:

2020 INSITE TOWERS SITES

OWNER:

INSITE TOWERS

PROPERTY DESCRIPTION:

PROPOSED NEW 10m x 10m SITE WITH
A 35m HIGH LATTICE AND
OUTDOOR EQUIPMENT PLINTHS

SITE ADDRESS:

LATITUDE:

-33.7939602

LONGITUDE:

23.6248031

SITE NAME:

LOUTERWATER

NUMBER:

ISSA 491

SURVEY DATE:

03/09/20

DRAWN BY:


SJVR

DATE:

04/09/20

DIMENSIONS TO BE VERIFIED ON SITE
BEFORE COMMENCEMENT OF ANY WORK.
DRAWINGS MUST NOT BE SCALED.
ONLY FIGURED DIMENSIONS TO BE USED.

LANDLORDS DETAIL:	CLIENT APPROVAL:	INSITE QC APPROVAL:	INSITE PROJECT MANAGER APPROVAL:	NO	DATE	DESCRIPTION
NAME:	NAME:	NAME:	NAME:	0	25/11/18	ISSUE FOR CONSTRUCTION
PHONE NO.:	SIGNATURE:	SIGNATURE:	SIGNATURE:	1	03/12/18	AS BUILT
DATE:	DATE:	DATE:	DATE:			

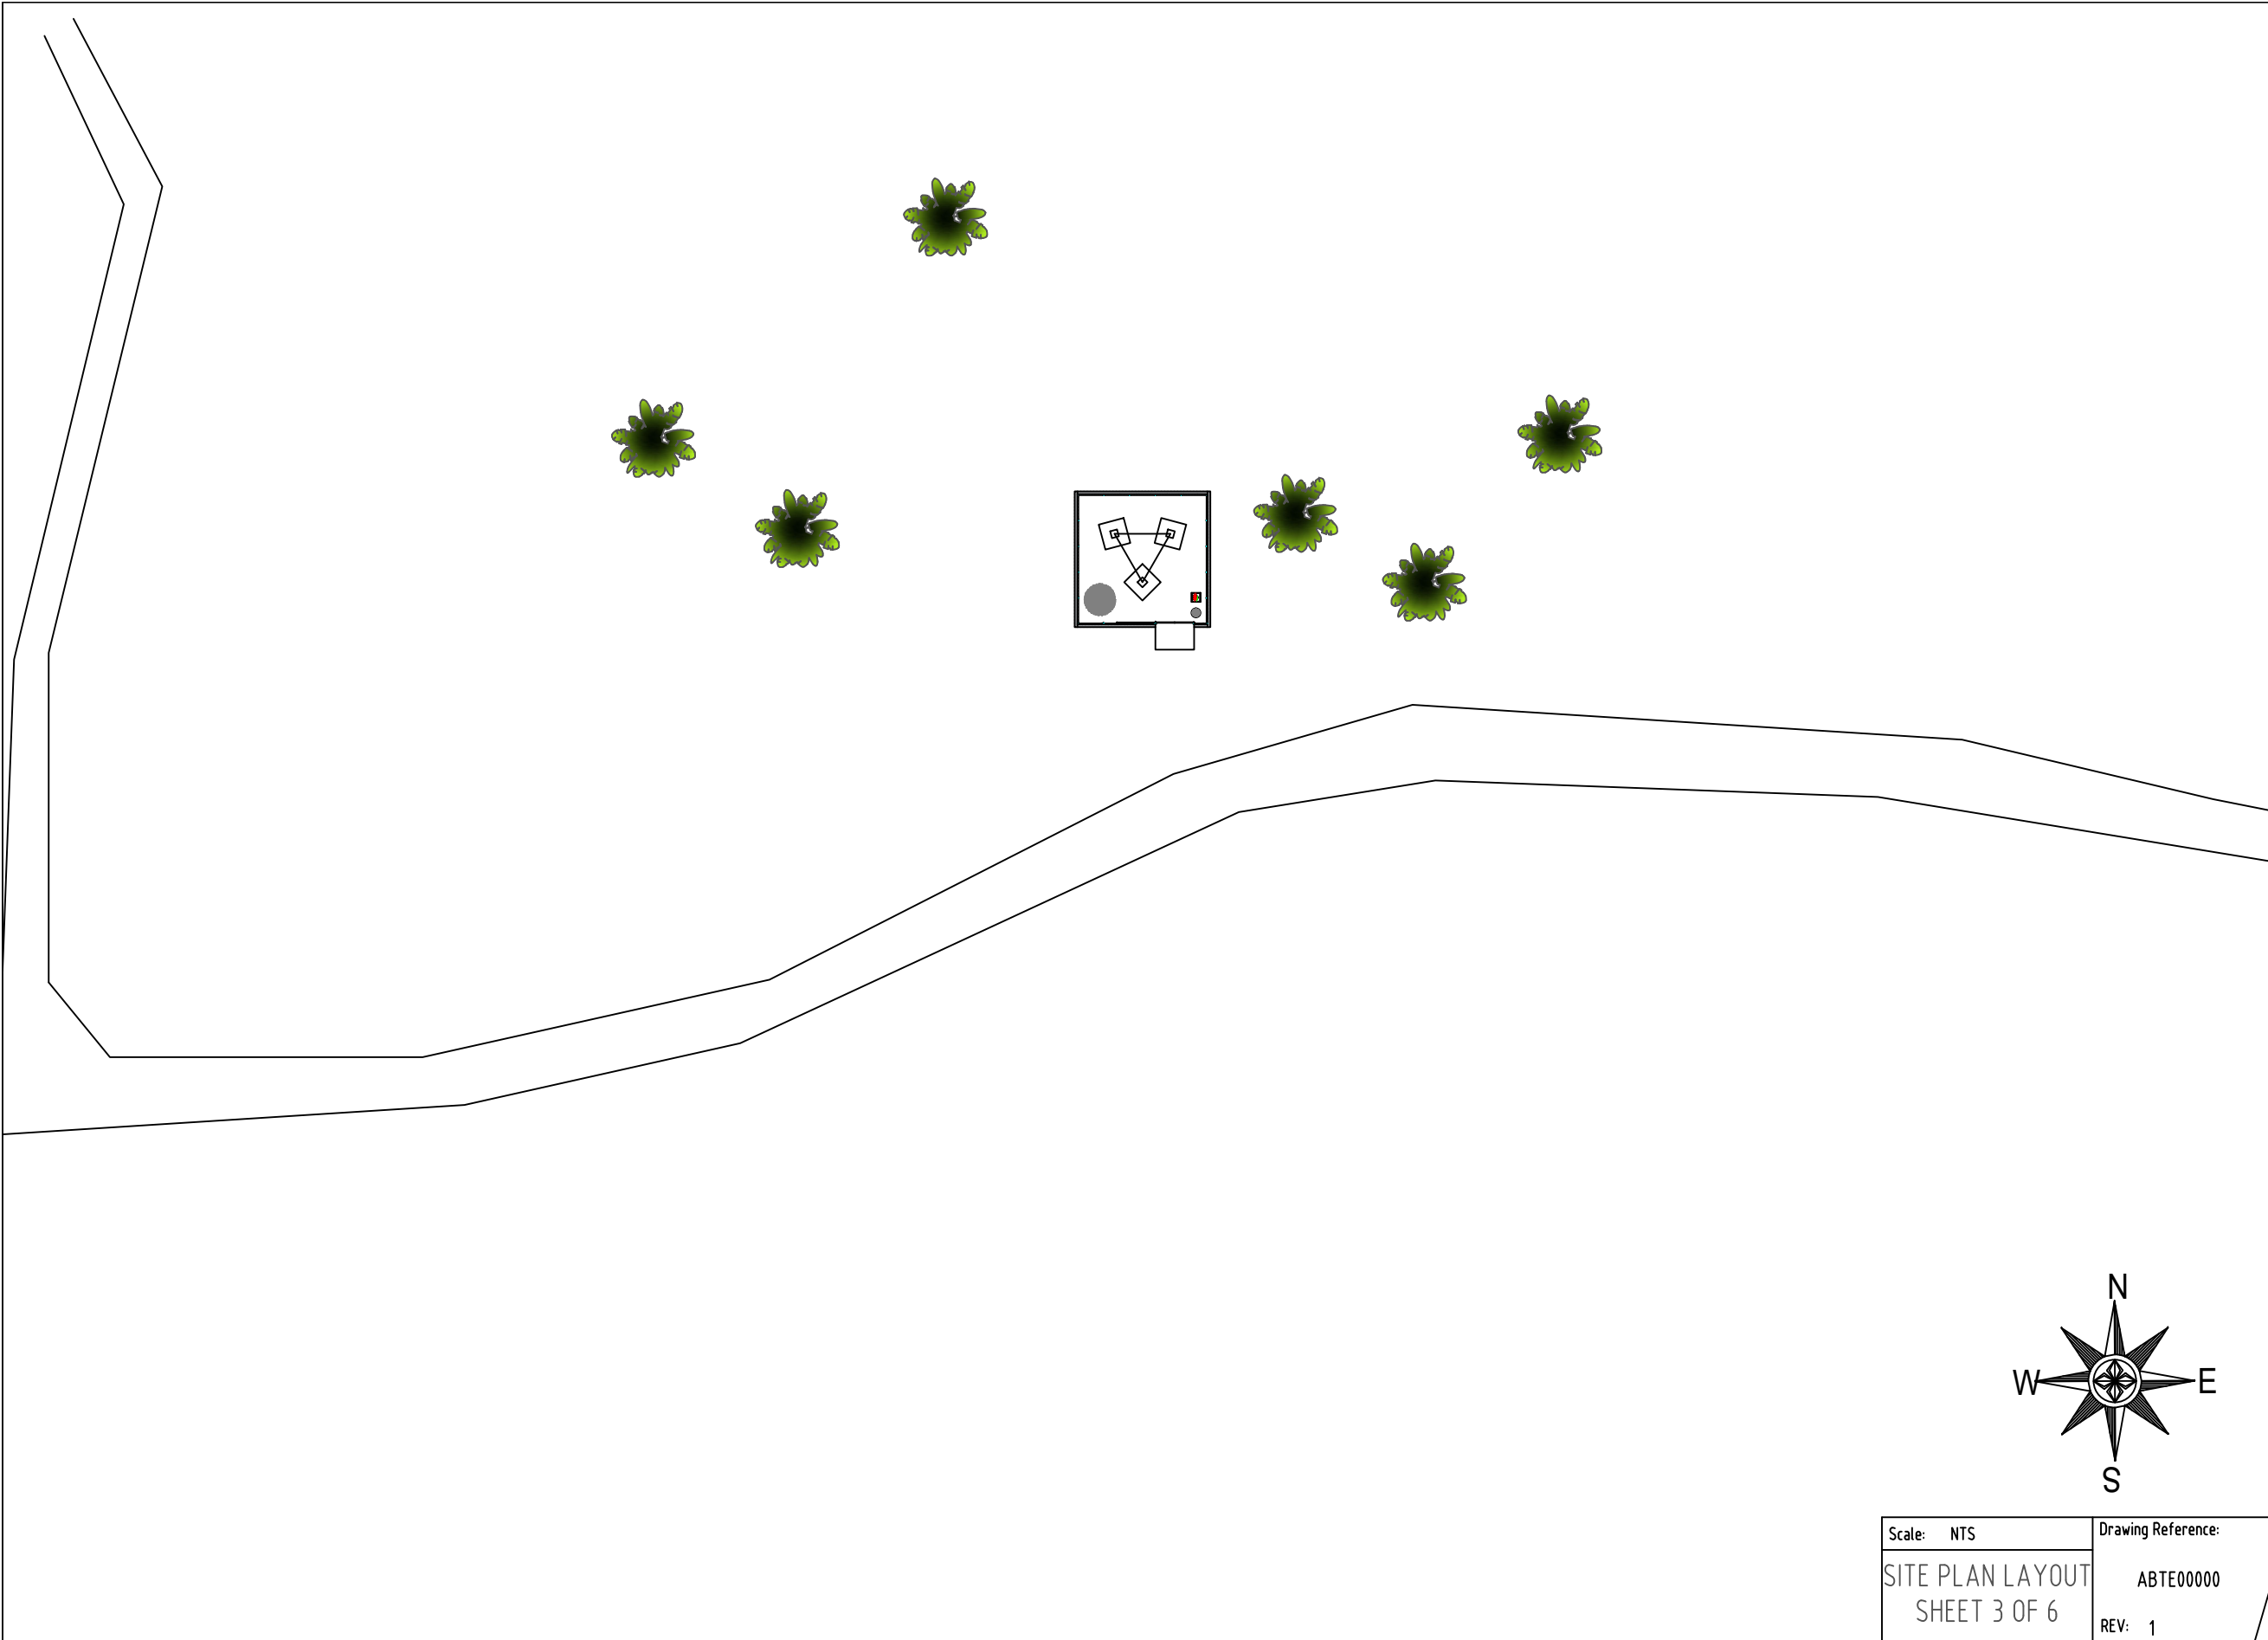

CLIENT:
Insite Towers
27 Vuna Close,
Umhlanga Ridge,
4319

TURN-KEY CONTRACTOR:
ABBOTT TECHNOLOGIES
ABBOTT TECHNOLOGIES
(PTY) LTD, UNIT 22 BRIAR
PARK, 10 QUEEN NANDI DRIVE,
BRIARDENE, DURBAN, 4051

NOTES:
1.
2.
3.
4.
5.
6.
7.
8.
9.
10.

PROJECT:
2020 INSITE TOWERS SITES

OWNER:
INSITE TOWERS

PROPERTY DESCRIPTION:
PROPOSED NEW 10m x 10m SITE WITH
A 35m HIGH LATTICE AND
OUTDOOR EQUIPMENT PLINTHS

SITE ADDRESS:
-

LATITUDE: -33.7939602

LONGITUDE: 23.6248031

SITE NAME:
LOUTERWATER


NUMBER:
ISSA 491

SURVEY DATE:
03/09/20

DRAWN BY:
S.JVR

DATE:
04/09/20

DIMENSIONS TO BE VERIFIED ON SITE
BEFORE COMMENCEMENT OF ANY WORK.
DRAWINGS MUST NOT BE SCALED.
ONLY FIGURED DIMENSIONS TO BE USED.

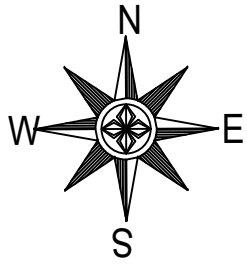


Scale: NTS
Drawing Reference:
ABTE00000
REV: 1

SITE PLAN LAYOUT
SHEET 3 OF 6

LANDLORDS DETAIL:		CLIENT APPROVAL:		INSITE QC APPROVAL:		INSITE PROJECT MANAGER APPROVAL:		NO	DATE	DESCRIPTION
NAME:		NAME:		NAME:		NAME:		0	25/11/18	ISSUE FOR CONSTRUCTION
PHONE NO.:		SIGNATURE:		SIGNATURE:		SIGNATURE:		1	03/12/18	AS BUILT
DATE:		DATE:		DATE:		DATE:				

10m x 10m PALISADE FENCE 2.4m HIGH
AS PER
SPECIFICATIONS AND DETAIL

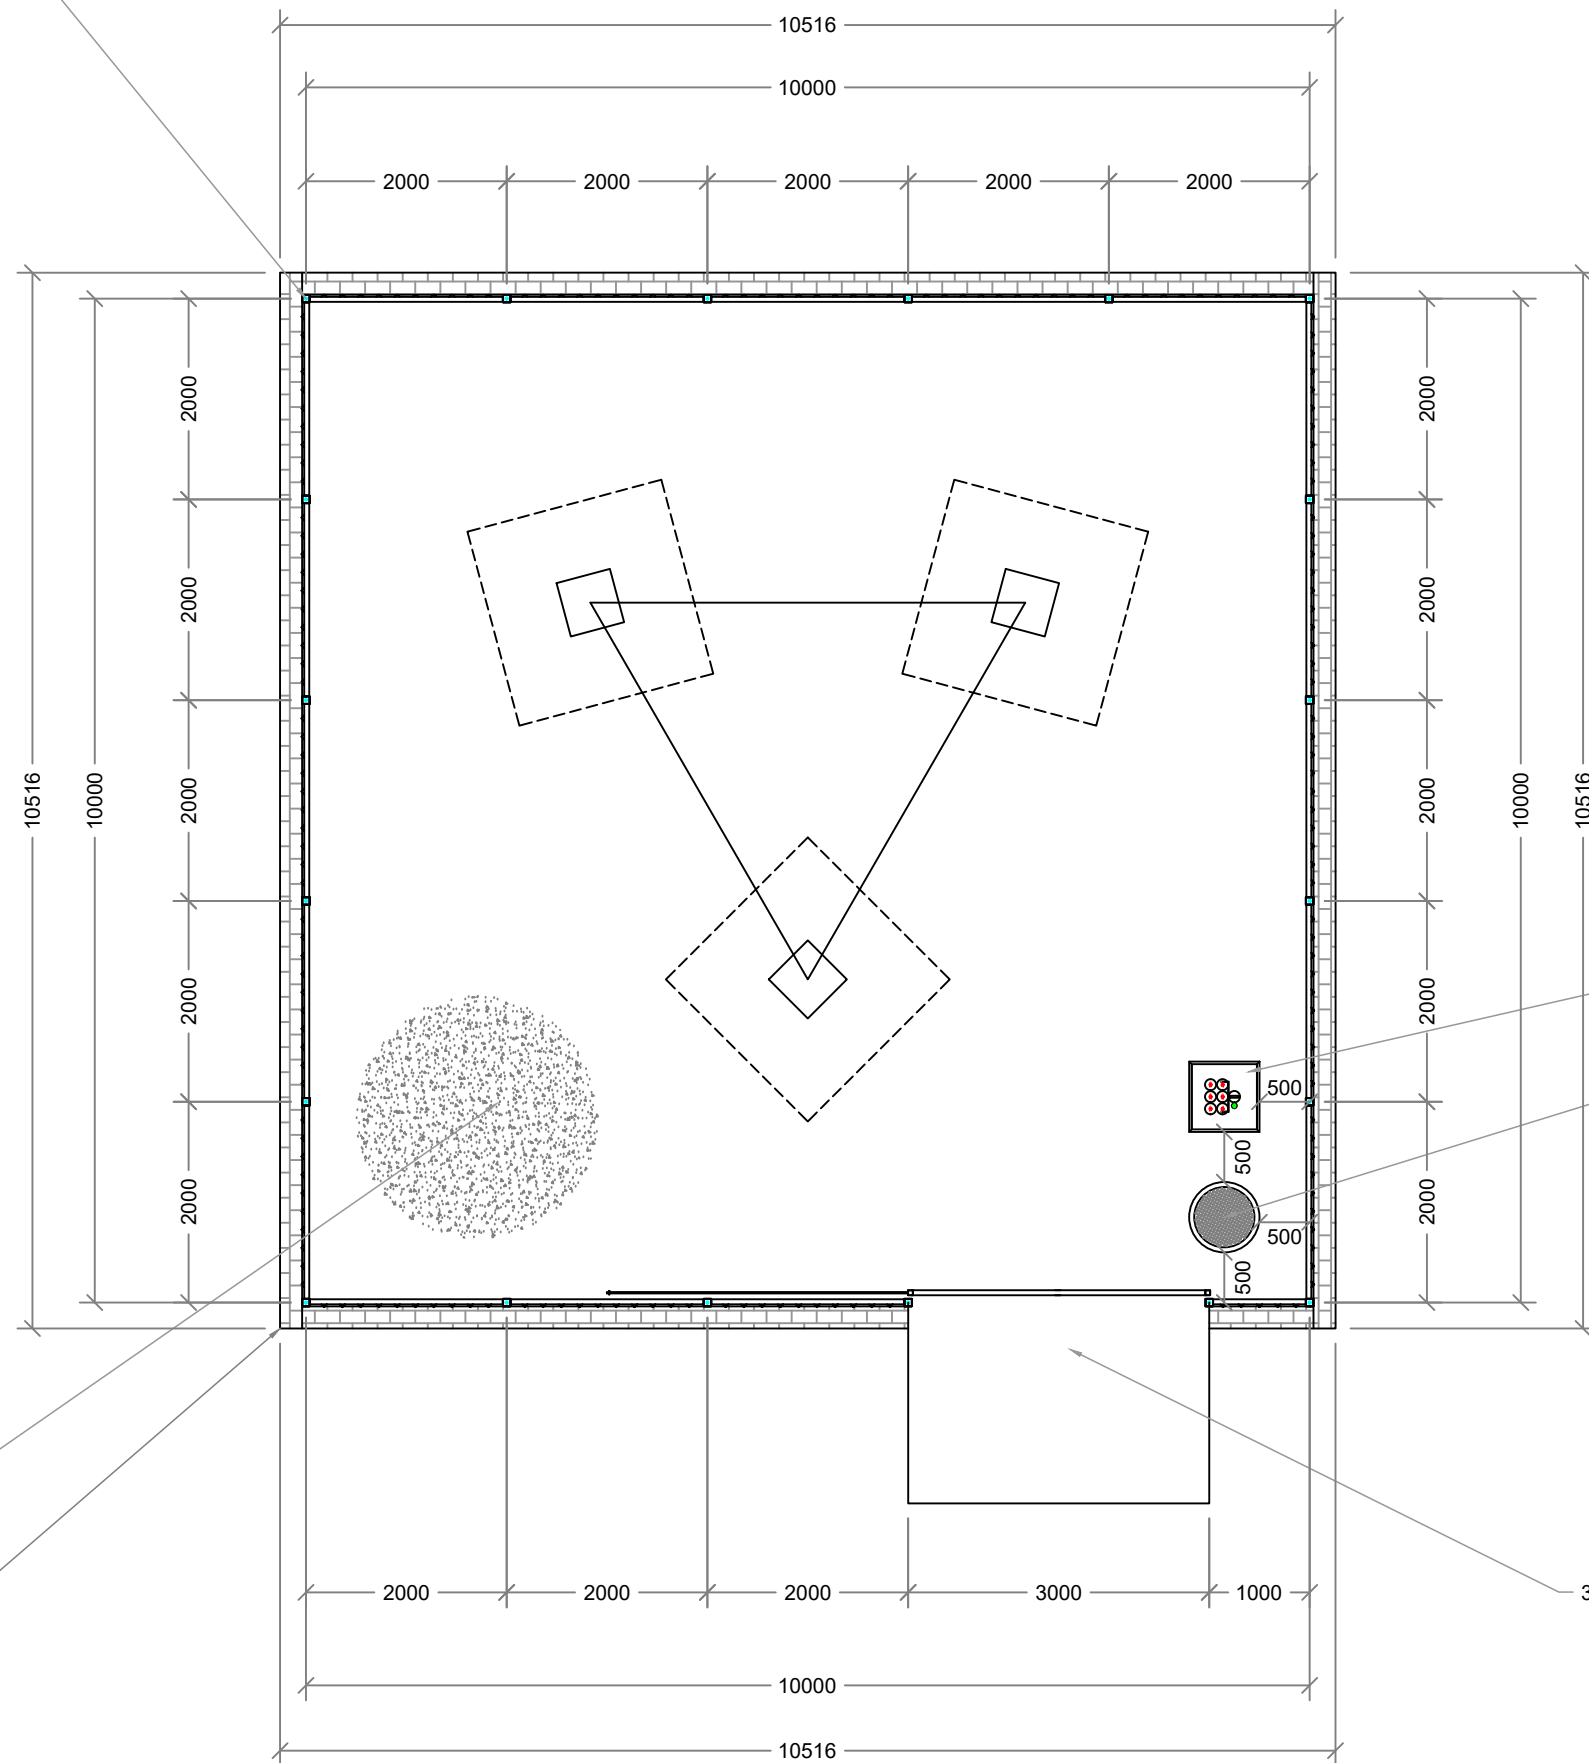

19mm STONE SHIP SITE INTERNAL


RETAINING WALL ALL AROUND

LEGEND	
	POWER CABLE
	RF CABLE
	OPTIC FIBRE
	TX CABLE

3m GATE WITH GATE RAMP

Scale: NTS	Drawing Reference:
BTS LAYOUT SHEET 4 OF 6	ABTE000000 REV: 1

LANDLORDS DETAIL:	CLIENT APPROVAL:	INSITE QC APPROVAL:	INSITE PROJECT MANAGER APPROVAL:	NO	DATE	DESCRIPTION
NAME:	NAME:	NAME:	NAME:	0	25/11/18	ISSUE FOR CONSTRUCTION
				1	03/12/18	AS BUILT
PHONE NO.:	SIGNATURE:	SIGNATURE:	SIGNATURE:			
DATE:	DATE:	DATE:	DATE:			

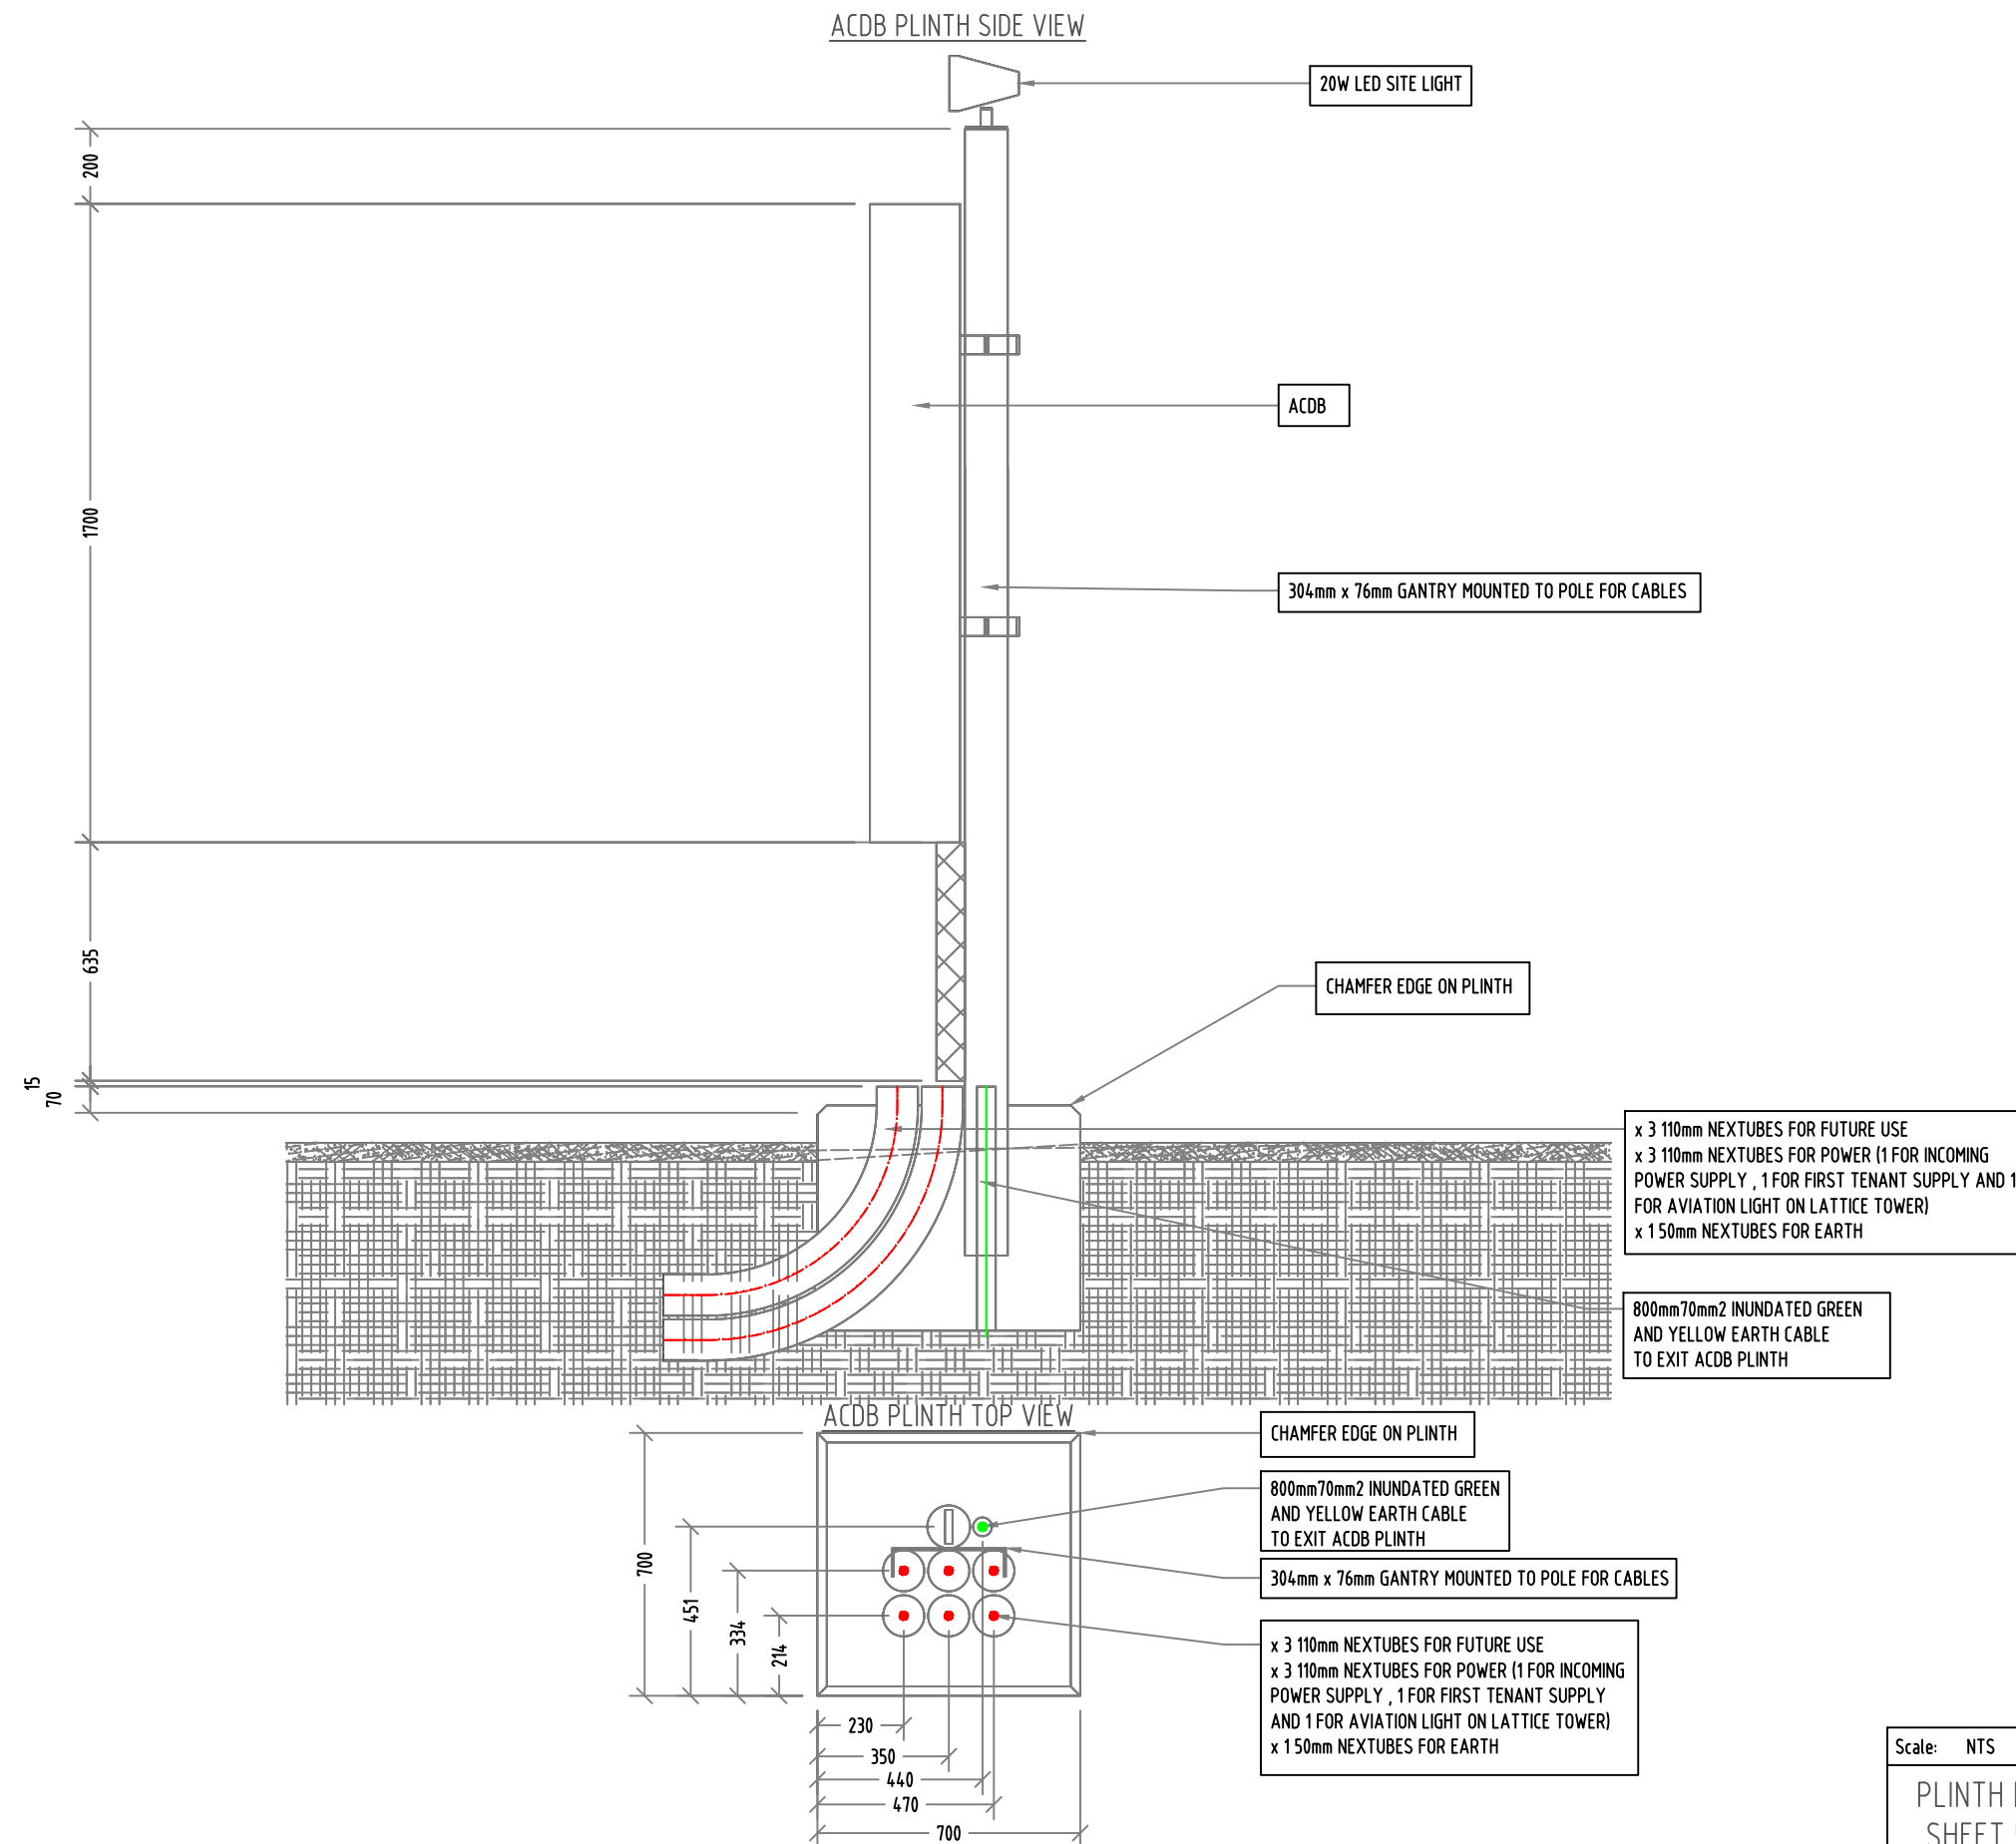

Scale: NTS

PLINTH DETAIL
SHEET 5 OF 6

Drawing Reference:
ABTE00000
REV: 1

CLIENT: **INSITE TOWERS,**
27 Vuna Close,
Umhlanga Ridge,
4319

TURN-KEY CONTRACTOR:
ABBOTT TECHNOLOGIES
ABBOTT TECHNOLOGIES
(PTY) LTD, UNIT 22 BRIAR
PARK, 10 QUEEN NANDI DRIVE,
BRIARDENE, DURBAN, 4051

NOTES:

-
-
PROJECT:

2020 INSITE TOWERS SITES

OWNER:

INSITE TOWERS

PROPERTY DESCRIPTION:

PROPOSED NEW 10m x 10m SITE WITH
A 35m HIGH LATTICE AND
OUTDOOR EQUIPMENT PLINTHS

SITE ADDRESS:

LATITUDE: -33.7939602

LONGITUDE: 23.6248031

SITE NAME:

LOUTERWATER

NUMBER:

ISSA 491

SURVEY DATE:

03/09/20

DRAWN BY:

SJVR


DATE:

04/09/20



DIMENSIONS TO BE VERIFIED ON SITE
BEFORE COMMENCEMENT OF ANY WORK.
DRAWINGS MUST NOT BE SCALED.
ONLY FIGURED DIMENSIONS TO BE USED.

LANDLORDS DETAIL:	CLIENT APPROVAL:	INSITE QC APPROVAL:	INSITE PROJECT MANAGER APPROVAL:	NO	DATE	DESCRIPTION
NAME:	NAME:	NAME:	NAME:	0	25/11/18	ISSUE FOR CONSTRUCTION
PHONE NO.:	SIGNATURE:	SIGNATURE:	SIGNATURE:	1	03/12/18	AS BUILT
DATE:	DATE:	DATE:	DATE:			

Antennae Key							
Sector	Azimuth	Antenna	Antenna Top Height	Mechanical Tilt	Electrical Tilt	Feeder Size	Feeder Length
1	TBA	TBA	TBA	TBA	TBA	TBA	TBA
2	TBA	TBA	TBA	TBA	TBA	TBA	TBA
3	TBA	TBA	TBA	TBA	TBA	TBA	TBA

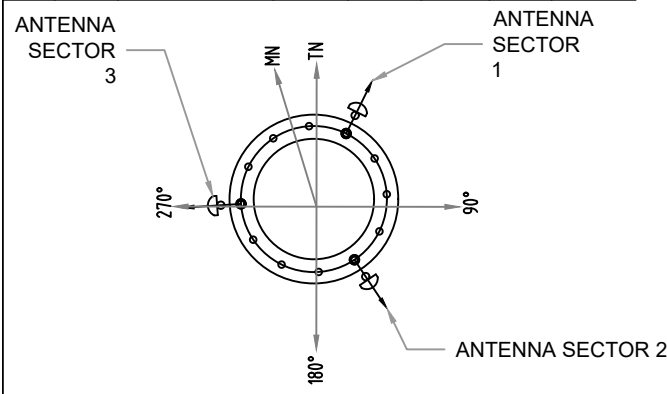

ANTENNA CONFIGURATION

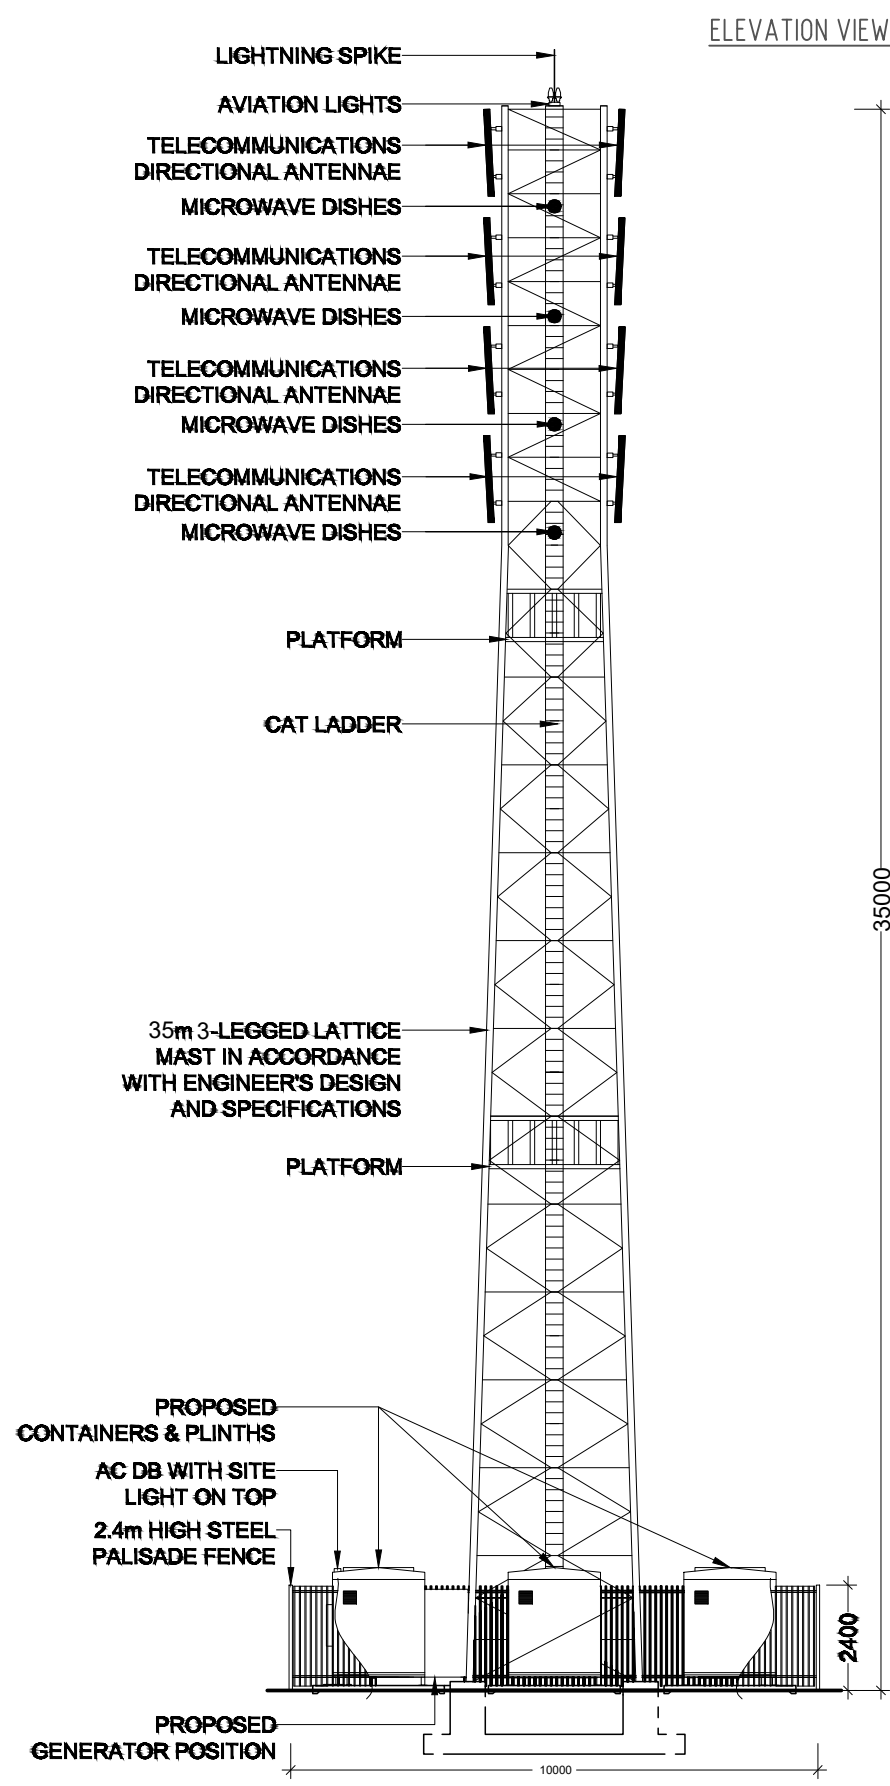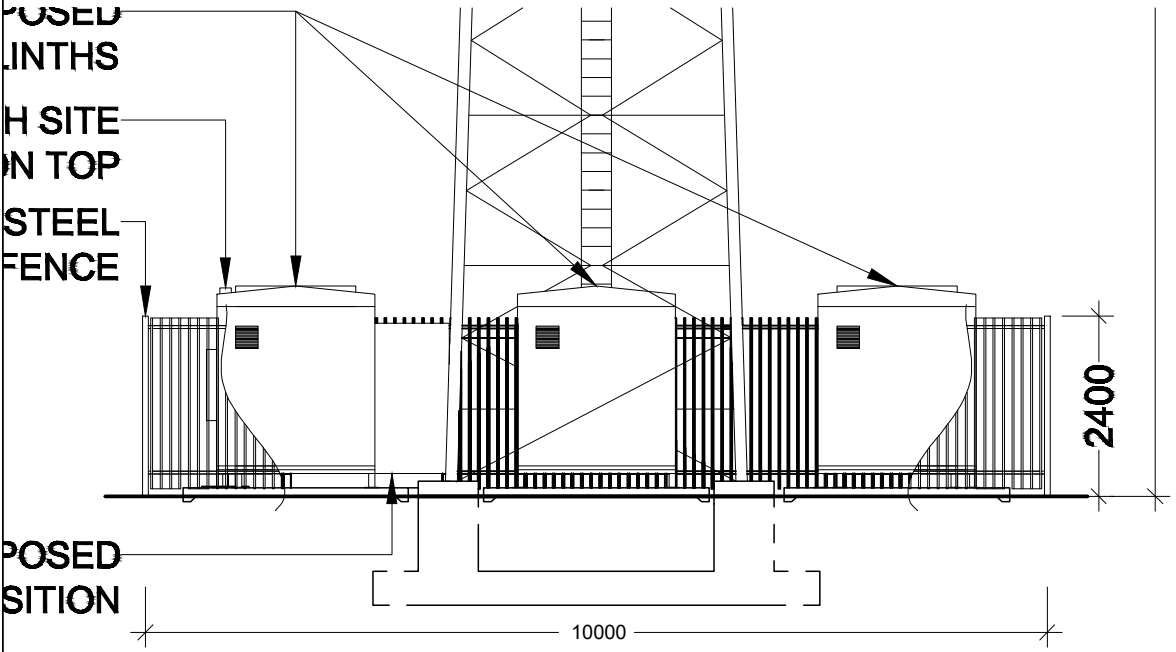

ELEVATION VIEW

Scale: NTS

ELEVATION SHEET 6 OF 6

Drawing Reference: ABTE00000

REV: 1

CLIENT:

Insite Towers

27 Vuna Close,
Umhlanga Ridge,
4319

TURN-KEY CONTRACTOR:

ABBOTT TECHNOLOGIES

ABBOTT TECHNOLOGIES (PTY) LTD, UNIT 22 BRIAR PARK, 10 QUEEN NANDI DRIVE, BRIARDENE, DURBAN, 4051

NOTES:

1.

2.

3.

4.

5.

6.

7.

8.

9.

10.

PROJECT:

2020 INSITE TOWERS SITES

OWNER:

INSITE TOWERS

PROPERTY DESCRIPTION:

PROPOSED NEW 10m x 10m SITE WITH A 35m HIGH LATTICE AND OUTDOOR EQUIPMENT PLINTHS

SITE ADDRESS:

LATITUDE:

-33.7939602

LONGITUDE:

23.6248031

SITE NAME:

LOUTERWATER

NUMBER:

ISSA 491

SURVEY DATE:

03/09/20

DRAWN BY:

SJVR

DATE:

04/09/20

DIMENSIONS TO BE VERIFIED ON SITE BEFORE COMMENCEMENT OF ANY WORK. DRAWINGS MUST NOT BE SCALED. ONLY FIGURED DIMENSIONS TO BE USED.

LANDLORDS DETAIL:		CLIENT APPROVAL:		INSITE QC APPROVAL:		INSITE PROJECT MANAGER APPROVAL:		NO	DATE	DESCRIPTION
NAME:		NAME:		NAME:		NAME:		0	25/11/18	ISSUE FOR CONSTRUCTION
PHONE NO.:		SIGNATURE:		SIGNATURE:		SIGNATURE:		1	03/12/18	AS BUILT
DATE:		DATE:		DATE:		DATE:				